BRUHAT BANGALORE MAHANAGARA PALIKE

Name of Work:Developments works to be under taken in Ward No.05 of BBMP around Solid Waste Disposal Processing units Bellahalli, Bagaluru and Kattigenahalli Byatarayanapura Constituency.

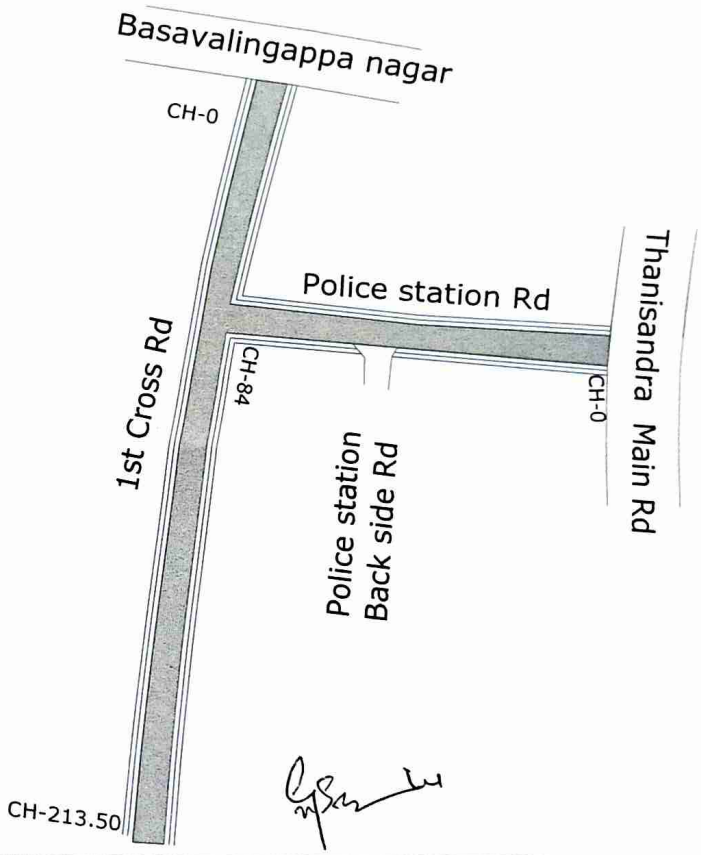

Basavalingappa Nagar Main road

NOTE:-

1. ALL DIMENSION & LEVELS ARE Mts. UNLESS OTHERWISE MENTIONED.

DATE	No. OF PRNTS	PRNTS ISSUED TO	SIGN

DATE	REVISION	DESCRIPTIONS	SIGN

LEGEND:-

ASPHALTED SURFACE

CONSULTANT

TEJUS CONSULTANTS

TITLE:

As Built Drawing

Asst. Executive Engineer
Project Division
Yelahanka Zone
Bangalore - 92

BRUHAT BANGALORE MAHANAGARA PALIKE

Name of Work:Developments works to be under taken in Ward No.05 of BBMP around Solid Waste Disposal Processing units Bellahalli, Bagaluru and Kattigenahalli Byatarayanapura Constituency.

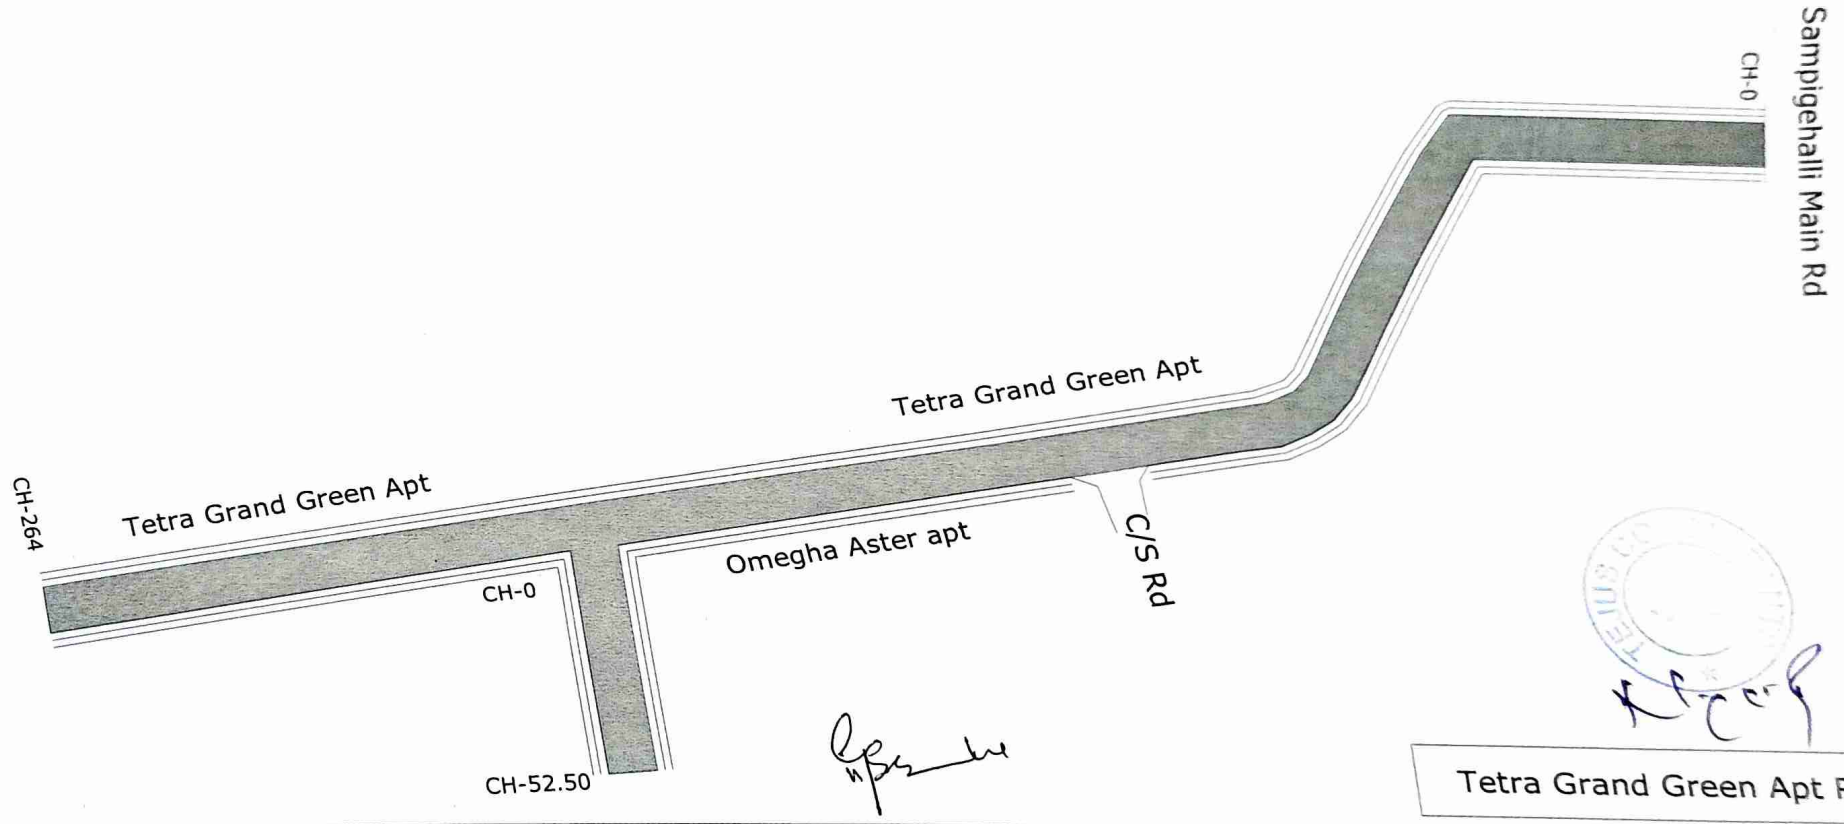

Tetra Grand Green Apt Road

NOTE:-

1 ALL DIMENSION & LEVELS ARE Mts. UNLESS OTHERWISE MENTIONED

DATE	No. OF PRINTS	PRINTS ISSUED TO	SIGN

DATE	REVISION	DESCRIPTIONS	SIGN

LEGEND:-

ASPHALTED SURFACE

CONSULTANT

TEJUS CONSULTANTS

TITLE

As Built Drawing

Asst. Executive Engineer

Division

Yelahanka Zone

GBMP Bangalore - 92

BRUHAT BANGALORE MAHANAGARA PALIKE

Name of Work:Developments works to be under taken in Ward No.05 of BBMP around Solid Waste Disposal Processing units Bellahalli, Bagaluru and Kattigenahalli Byatarayanapura Constituency.

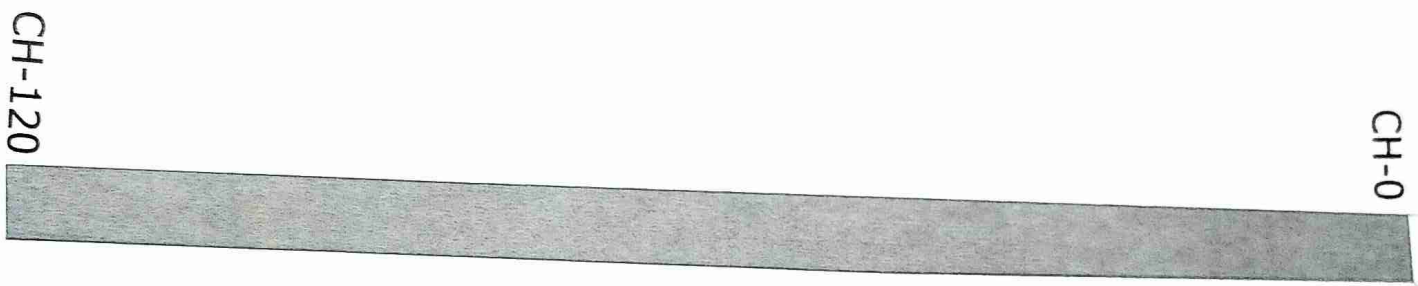

Shrusti Enclave Apartment

Shrusti Enclave Apartment Road

NOTE.-

1 ALL DIMENSION & LEVELS ARE Mts. UNLESS OTHERWISE MENTIONED.

DATE	No. OF PRINTS	PRINTS ISSUED TO	SIGN

DATE	REVISION	DESCRIPTIONS	SIGN

LEGEND.-

ASPHALTED SURFACE

Asst. Executive Engineer
Division
Zone
TSMP, Bangalore - 92

CONSULTANT

TEJUS CONSULTANTS

TITLE

As Built Drawing

BRUHAT BANGALORE MAHANAGARA PALIKE

Name of Work:Developments works to be under taken in Ward No.05 of BBMP around Solid Waste Disposal Processing units Bellahalli, Bagaluru and Kattigenahalli Byatarayanapura Constituency.

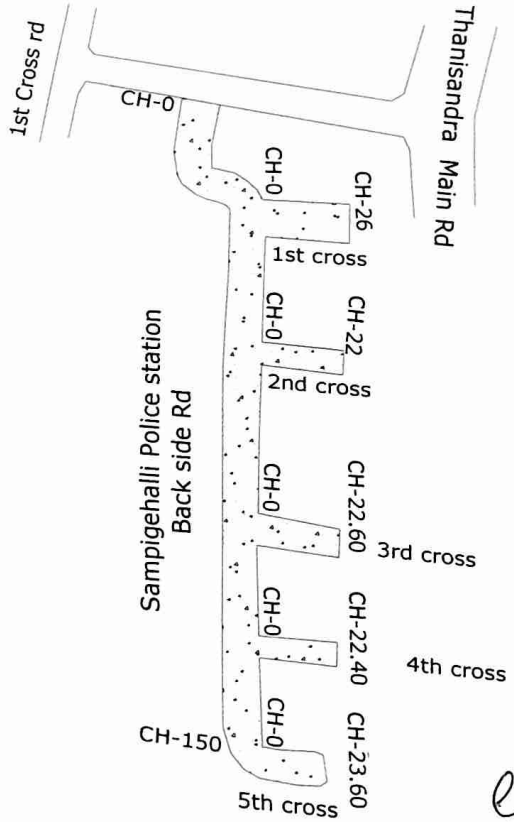

Sampigehalli Police station
Back side Rd

NOTE :
1 ALL DIMENSION & LEVELS ARE Mts. UNLESS OTHERWISE MENTIONED

DATE	No. OF PRINTS	PRINTS ISSUED TO	SIGN

DATE	REVISION	DESCRIPTIONS	SIGN

LEGEND :-

CEMENT CONCRETE ROAD

CONSULTANT

TEJUS CONSULTANTS

TITLE

As Built Drawing

Asst. Executive Engineer
Division
Zone

BRUHAT BANGALORE MAHANAGARA PALIKE

Name of Work:Developments works to be under taken in Ward No.05 of BBMP around Solid Waste Disposal Processing units Bellahalli, Bagaluru and Kattigenahalli Byatarayanapura Constituency.

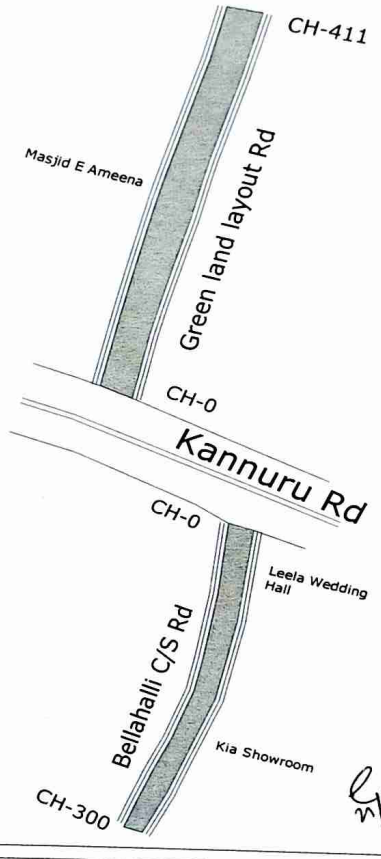

Green land layout Rd
Bellahalli C/S Rd

NOTE:-
1 ALL DIMENSION & LEVELS ARE Mts. UNLESS OTHERWISE MENTIONED.

DATE	No. OF PRINTS	PRINTS ISSUED TO	SIGN

DATE	REVISION	DESCRIPTIONS	SIGN

LEGEND:-
ASPHALTED SURFACE

CONSULTANT
TEJUS CONSULTANTS

TITLE
As Built Drawing

Asst. Executive Engineer
Division
Zone
BBMP Bangalore - 92

BRUHAT BANGALORE MAHANAGARA PALIKE

Name of Work:Developments works to be under taken in Ward No.05 of BBMP around Solid Waste Disposal Processing units Bellahalli, Bagaluru and Kattigenahalli Byatarayanapura Constituency.

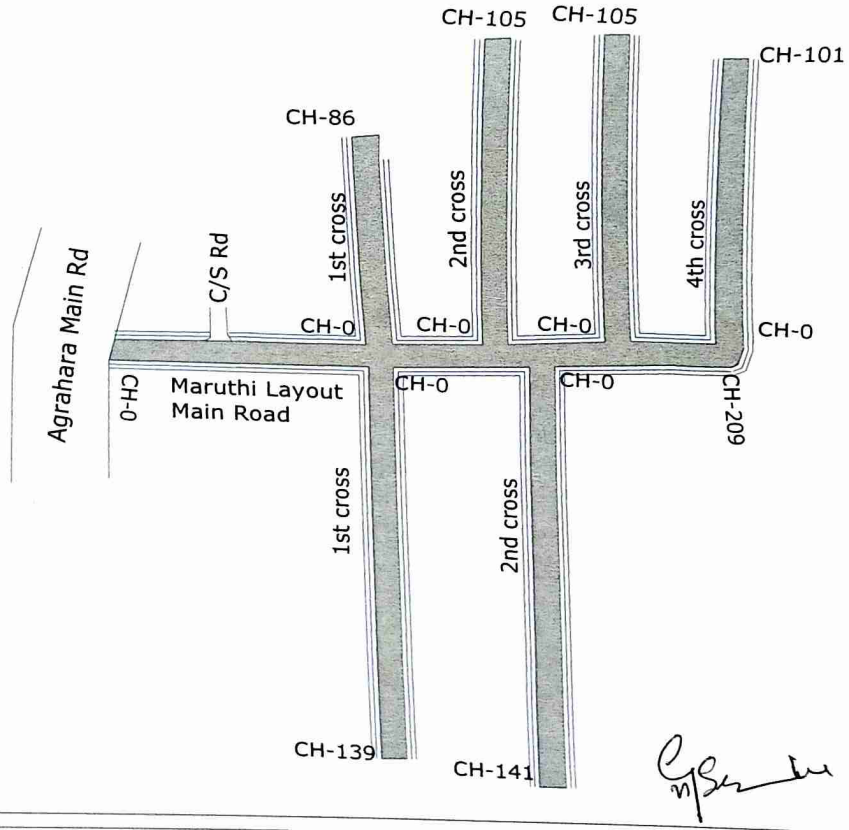

Maruthi layout Roads

NOTE

1. ALL DIMENSION & LEVELS ARE Mts UNLESS OTHERWISE MENTIONED.

DATE	No. OF PRINTS	PRINTS ISSUED TO	SIGN

DATE	REVISION	DESCRIPTIONS	SIGN

LEGEND :-

ASPHALTED SURFACE

CONSULTANT

TEJUS CONSULTANTS

No.58 M.G. 6th Cross, 3rd Main
1st Stage, Basaveshwaranagar
Bangalore-560079
TEL: 080 - 23287532
email: tejusconsultancy@gmail.com

TITLE

As Built Drawing

1/1

Asst. Executive Engineer
Division
Yelahanka Zone
Bangalore - 92